

Partitioning	New	Existing
Solid Insulated Gyprock Partition		
Solid Gyprock Partition With Glazing Over		
Full Height Glazed Partition		
Window Treatments		
Feature Treatment P = Paint C = Cloth F = Film		
Door Reference Indicator L = Lock C = Closer		
Elevation Cross Reference		
Electrical & Communications	New	Existing
Single General Power Outlet		
Double General Power Outlet		
Single Data/Comms Outlet		
Data Data/Comms Outlet		
Light Switch		
Residual Current Device		
TV Outlet		
Air Con. Thermostat		
Floor Box		
Ducted Skirting		
Telephone Outlet		
Power Dock - 4 GPO, 2 DATA		
Lighting	New	Existing
Recessed Fluorescent Light		
Recessed Low Voltage Down Light		
Recessed Fluorescent Down Light		
Wall Light		
Motion Sensor		
Speaker		
Ceiling Level Indicator		
CL=####mm		
Fire and Safety	New	Existing
Emergency Luminaire		
Fire Sprinkler		
Thermal/Smoke Detector		
Exit Sign		
Directional Exit Sign		
Ceiling Mounted Security Sensor		
Security Sensor		
Fire Hose Reel		
Fire Extinguisher		
Mechanical	New	Existing
Supply Air Grill		
Return Air Grill		
Screens	New	Existing
1250mm High, All Solid, Fabric Covered "Fabric 01"		
1250mm High, All Solid, Fabric Covered "Fabric 01"		
1250mm High, All Solid, Fabric Covered "Fabric 02"		
1250mm High, All Solid, Fabric Covered "Fabric 02"		
Furniture	New	Existing
Furniture Detailed by Trojan Horse Interiors		
Relocate Existing Furniture to New Site		
Colours & Finishes Cross Reference		

GENERAL NOTE:  
FHG = Full Height Glass  
FHG + Film = Full Height Glass and selected film applied to glass



As Constructed Floor Plan DWG - 02A

New Standard Energy 0872 - 02A


Level 2  
7 Ventnor Street  
West Perth WA 6005

**AS CONSTRUCTED**

Giulia Grattoggi 1:50 A1 11/01/2013

22 Railway Road, Subiaco WA 6008 T 9388 9911 F 9388 9992

All drawings and documents remain the property of Trojan Horse Interiors and are subject to copyright. This drawing must not be reproduced in whole or part without written consent from Trojan Horse Interiors. Contractors to verify all dimensions on site. Please contact Trojan Horse Interiors of any discrepancies prior to commencing works.

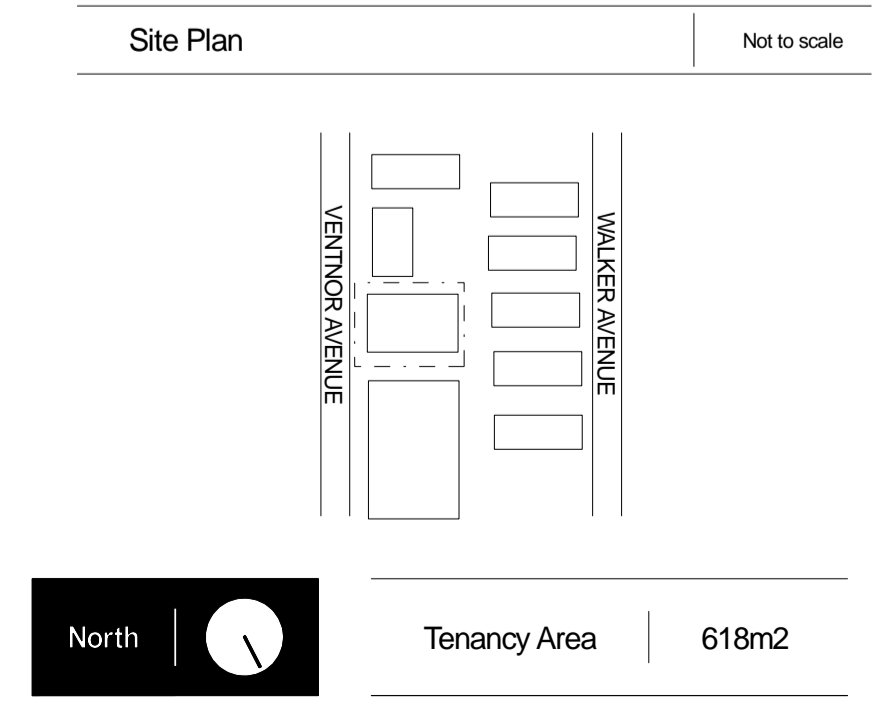

Tenancy Area 618m<sup>2</sup>